
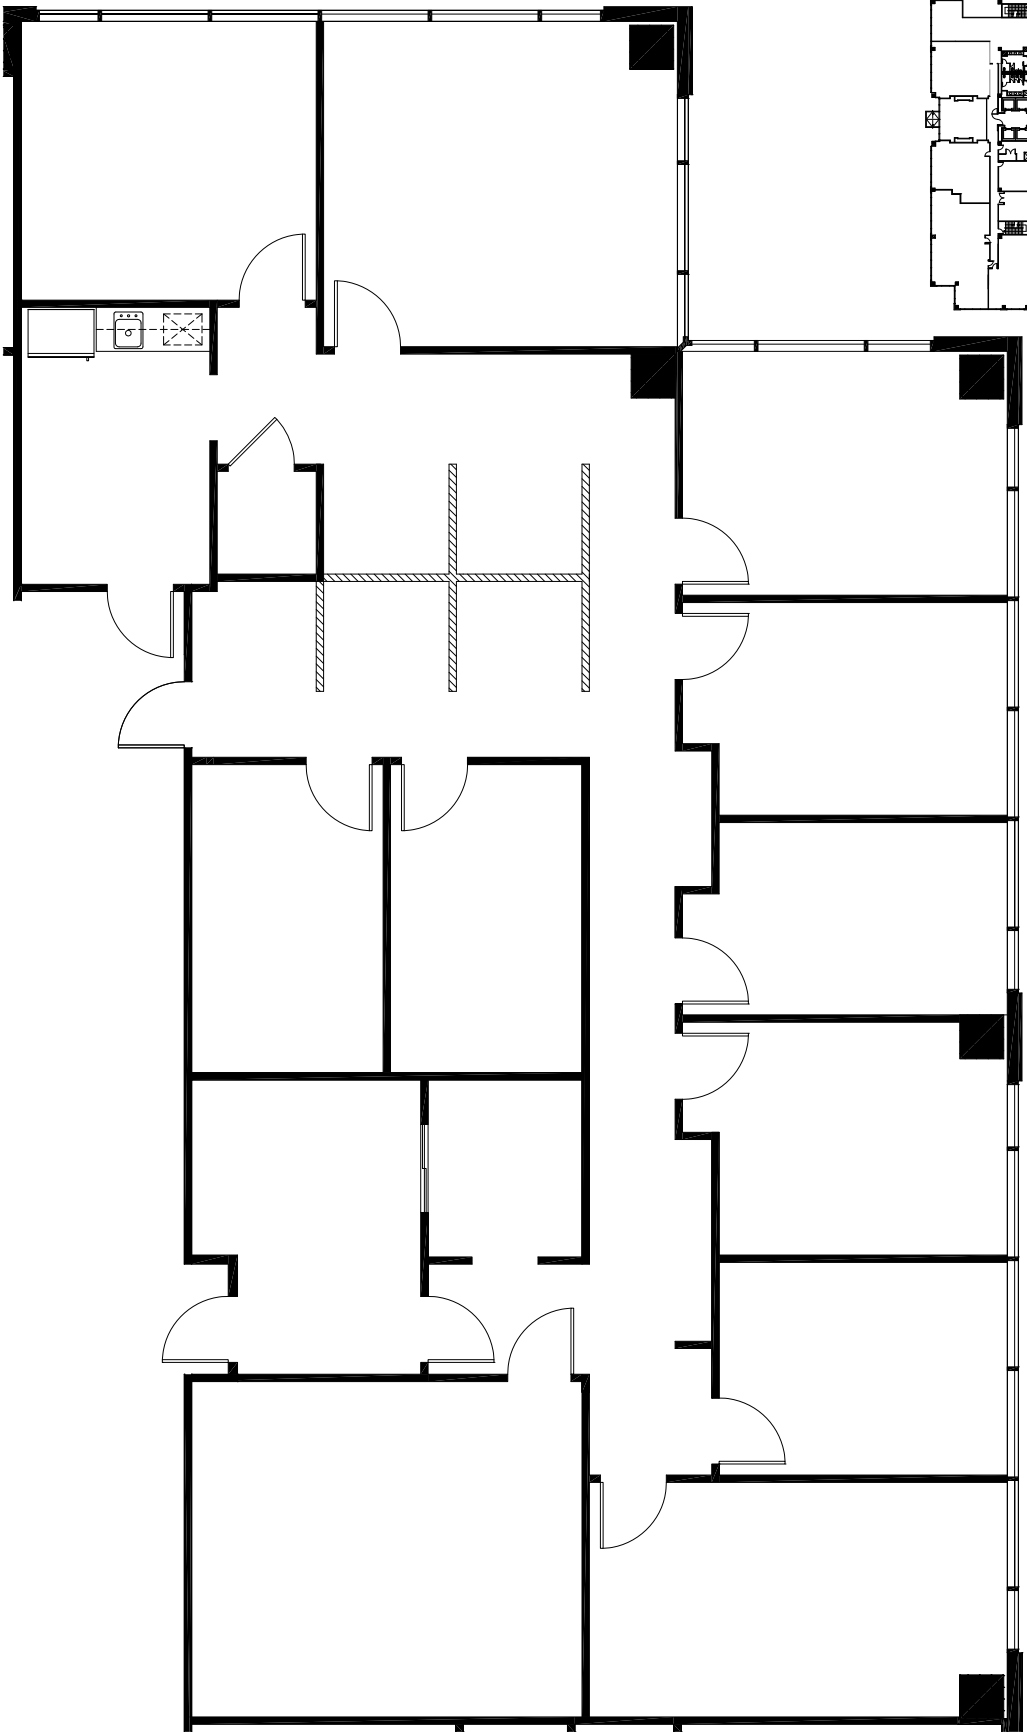


Key Plan: 3,297 RSF

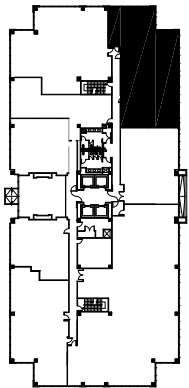


Marketing Plan

Record Drawing, 3-1-10

Suite 201, 2591 Dallas Pkwy., Hall Office Park

Leasing Information: Kim Butler or Tammy Lomonaco at 972-377-1100  
kbutler@hallfinancial.com or tlomonaco@hallfinancial.com

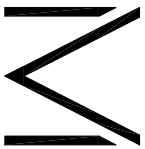

TAMARA VAUGHAN MYERS  
VAUGHAN MYERS DESIGN, INC.  
2707 SIR BEDIVERE LANE  
LEWISVILLE, TEXAS 75056  
PHONE: 972.899.0922  
FAX: 1.888.255.0292  
Tamara@VMDesignInc.com



HALL OFFICE PARK  
www.hallofficepark.com