



Key Plan: 1,695 RSF

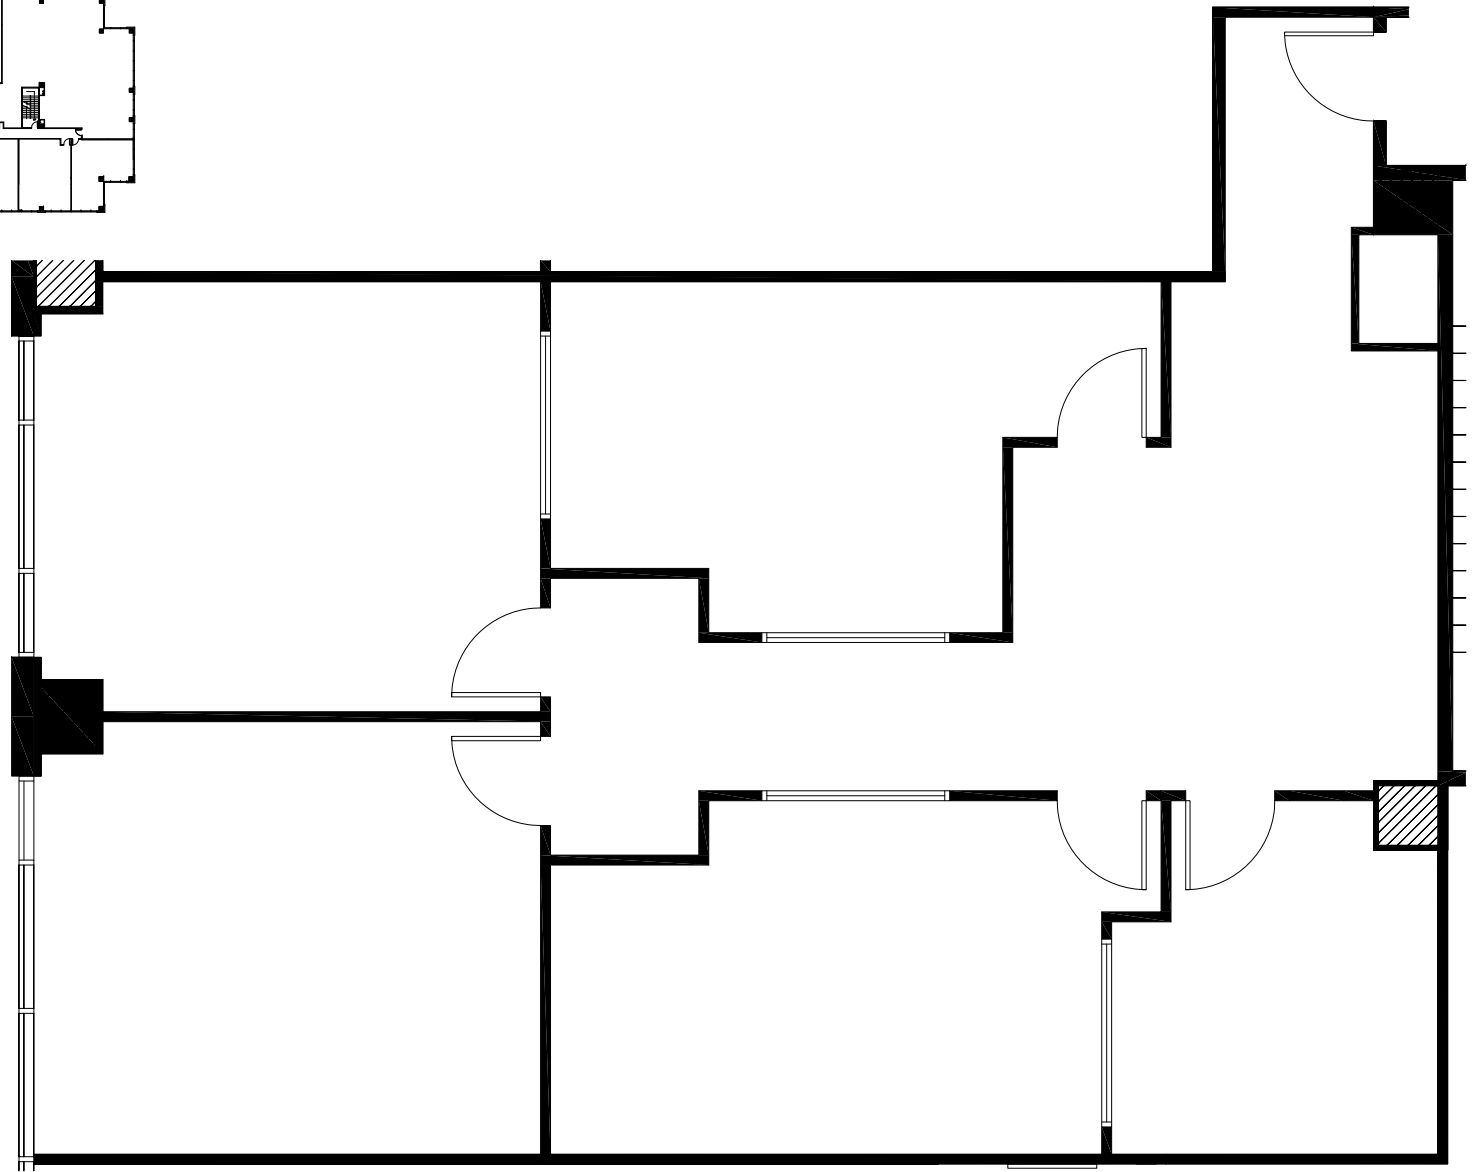

**M** TAMARA VAUGHAN MYERS  
VAUGHAN MYERS DESIGN, INC.  
2707 SIR BEDIVERE LANE  
LEWISVILLE, TEXAS 75056  
PHONE: 972.899.0922  
FAX: 1.888.255.0292  
Tamara@VMDesignInc.com

Marketing Plan  
Record Drawing, 3-1-10  
Suite 406, 2591 Dallas Pkwy., Hall Office Park A2  
Leasing Information: Kim Butler or Tammy Lomonaco at 972-377-1100  
kbutler@hallfinancial.com or tlomonaco@hallfinancial.com

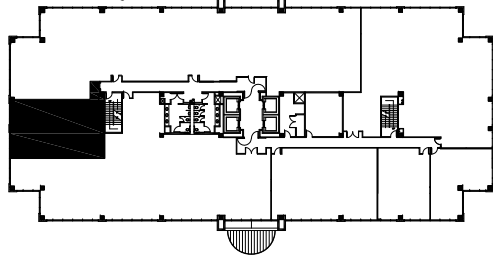

**HALL OFFICE PARK**  
www.hallofficepark.com