


Key Plan: 4,270 RSF

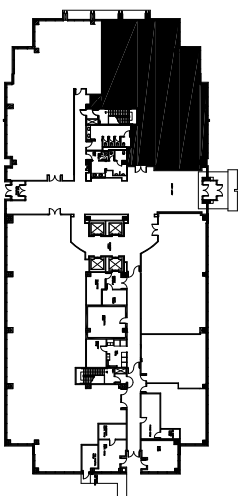


Marketing Plan

Record Drawing, 3-1-10

Suite 101, 2601 Network Blvd., Hall Office Park C1

Leasing Information: Kim Butler or Tammy Lomonaco at 972-377-1100
 kbutler@hallfinancial.com or tlomonaco@hallfinancial.com

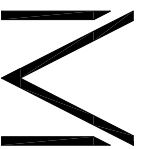

TAMARA VAUGHAN MYERS
 VAUGHAN MYERS DESIGN, INC.
 2707 SIR BEDDYERE LANE
 LEWISVILLE, TEXAS 75066
 PHONE: 972.899.0922
 FAX: 1.888.255.0292
 Tamara@VMDdesigninc.com



HALL OFFICE PARK
 www.hallofficepark.com