


Key Plan:
1,033 RSF

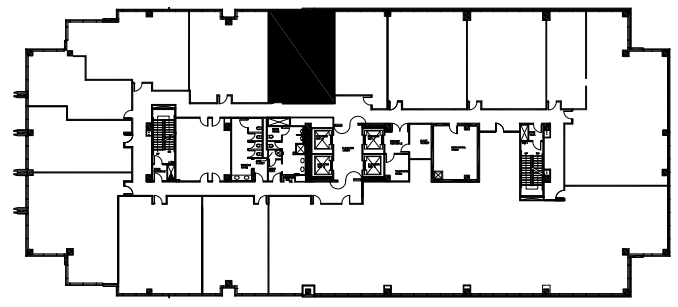

M TAMARA VAUGHAN MYERS
 VAUGHAN MYERS DESIGN, INC.
 2707 SIR BEDIVERE LANE
 LEWISVILLE, TEXAS 75056
 PHONE: 972.899.0922
 FAX: 1.888.255.0292
 Tamara@VMDesignInc.com

Marketing Plan
 Record Drawing, 3-29-10
 Suite 412, 2601 Network Blvd., Hall Office Park C1
 Leasing Information: Kim Butler or Tammy Lomonaco at 972-377-1100
 kbutler@hallfinancial.com or tlomonaco@hallfinancial.com



HALL OFFICE PARK
 www.hallfinancial.com