


Key Plan: 7,260 RSF

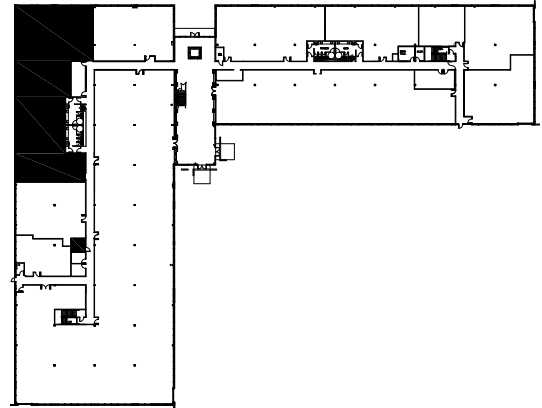

**M** TAMARA VAUGHAN MYERS  
 VAUGHAN MYERS DESIGN, INC.  
 2707 SIR BEDIVERE LANE  
 LEWISVILLE, TEXAS 75056  
 PHONE: 972.899.0922  
 FAX: 1.888.255.0292  
 Tamara@VMDesignInc.com

Marketing Plan  
 Record Drawing, 4-8-09  
 Suite 105, 2611 Internet Blvd., Hall Office Park G2  
 Leasing Information: Kim Butler or Tammy Lomonaco at 972.377.1100  
 kbutler@hallfinancial.com or tlomonaco@hallfinancial.com



**HALL OFFICE PARK**  
 www.hallofficepark.com