



Key Plan: 18,224 RSF

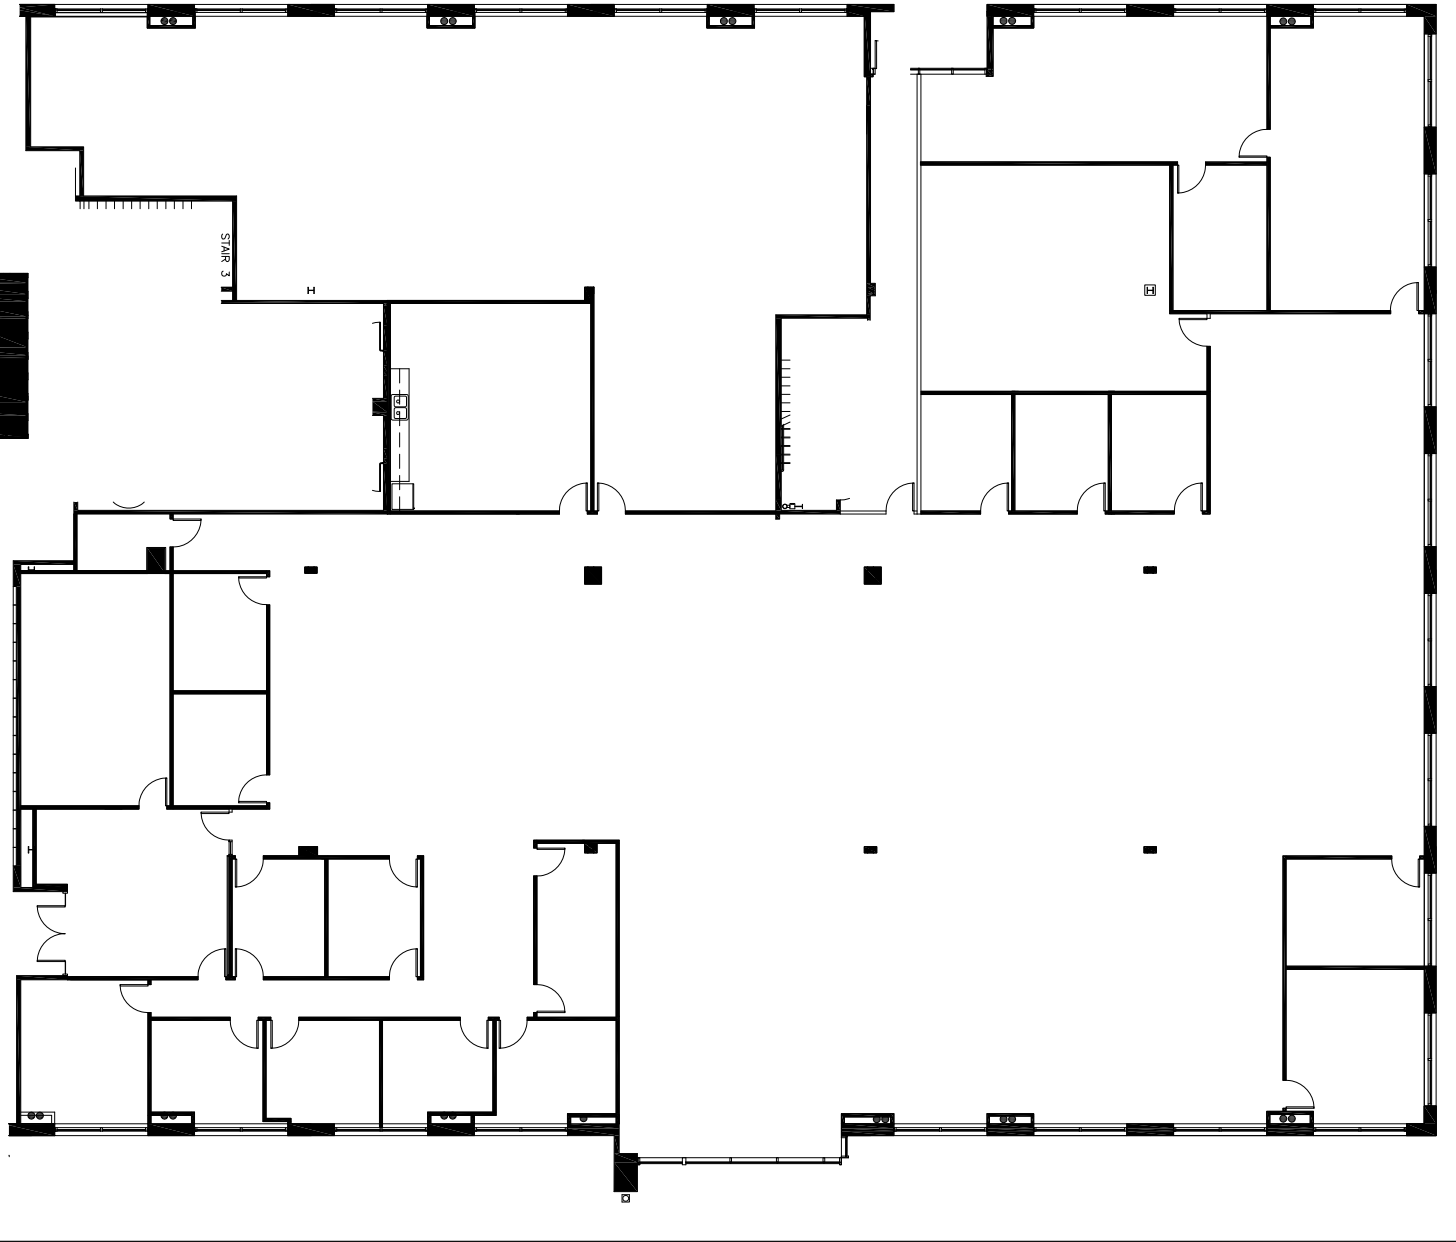

M TAMARA VAUGHAN MYERS
VAUGHAN MYERS DESIGN, INC.
2707 SIR BEDIVERE LANE
LEWISVILLE, TEXAS 75056
PHONE: 972.899.0922
FAX: 1.888.255.0292
Tamara@VMDesignInc.com

Marketing Plan
Record Drawing, 3-05-09
Suite 100, 3011 Internet Blvd., Hall Office Park G4
Leasing Information: Kim Butler or Tammy Lomonaco at 972.377.1100
kbutler@hallfinancial.com or tlomonaco@hallfinancial.com

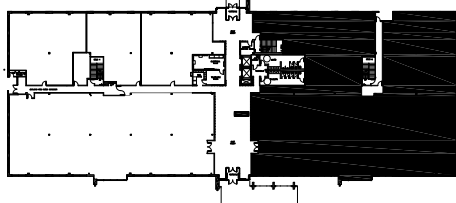

HALL OFFICE PARK
www.hallofficepark.com